

COMMITTEE OF THE WHOLE APRIL 4, 2005

STREET NAME APPROVAL FILE 19T-04V07
MACKENZIE GLEN DEVELOPMENTS LIMITED

Recommendation

The Commissioner of Planning recommends:

THAT the following street name for Draft Plan of Subdivision File 19T-04V07 (Mackenzie Glenn Developments Limited) BE APPROVED:

<u>STREET</u>	<u>PROPOSED NAME</u>
Street 'A'	Leor Court

Background

The subject lands shown on Attachment #1 are located northwest of Keele Street and McNaughton Road, on the north side of Cunningham Drive, in Lot 23, Concession 4, City of Vaughan.

The applicant has submitted a street name for approval. The draft plan of subdivision (19T-04V07) shown on Attachment #2 was approved by Vaughan Council on December 6, 2004. The Planning Department for the Region of York does not have any objection to the proposed street name.

Vaughan Staff has also reviewed the proposed street name, which is considered to be satisfactory.

Relationship to Vaughan Vision 2007

This staff report is consistent with the priorities set forth in Vaughan Vision 2007, particularly 'A-5', "Plan and Manage Growth".

Conclusion

Staff has no objection with the proposed street name for approved draft plan of subdivision 19T-04V07.

Attachments

1. Location Map
2. Plan showing proposed street

Report prepared by:


Jack McAllister, Senior GIS Technician, ext. 8209
Grant Uyeyama, Manager of Development Planning, ext. 8635

Respectfully submitted,

JOHN ZIPAY
Commissioner of Planning

MARCO RAMUNNO
Director of Development Planning

/LG

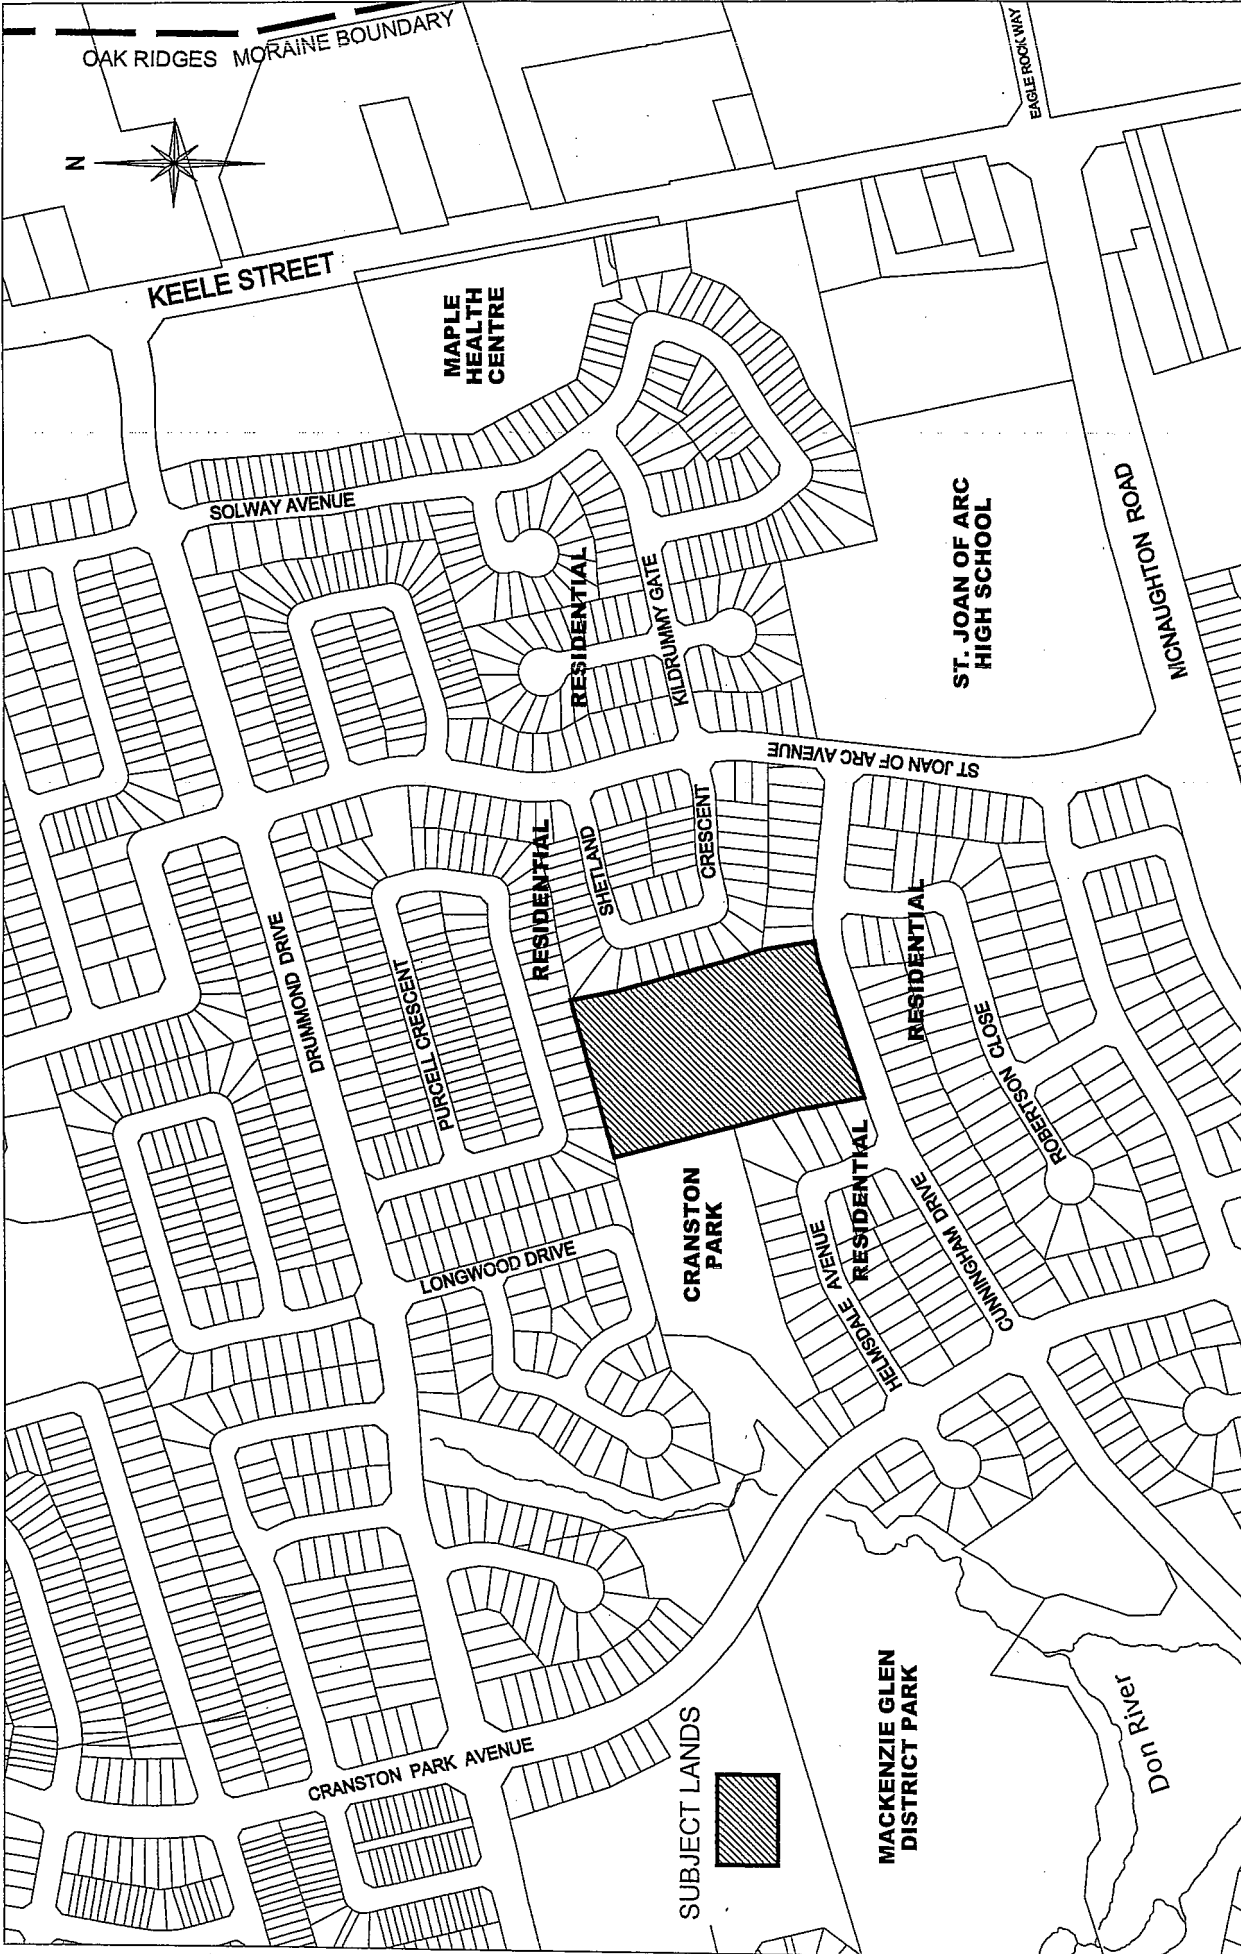

Attachment
 FILE No.: 19T-04V07
 Not to Scale
 March 9, 2005


City of **Vaughan**

Development Planning Department

Location Map

Part Lot 23,
 Concession 4
 APPLICANT:
 MACKENZIE GLEN DEVELOPMENTS LIMITED
 N:\DFT\ ATTACHMENTS\19\191-04V07

CITY OF VAUGHAN
 RED-LINED PLAN
 (DECEMBER 6, 2004)

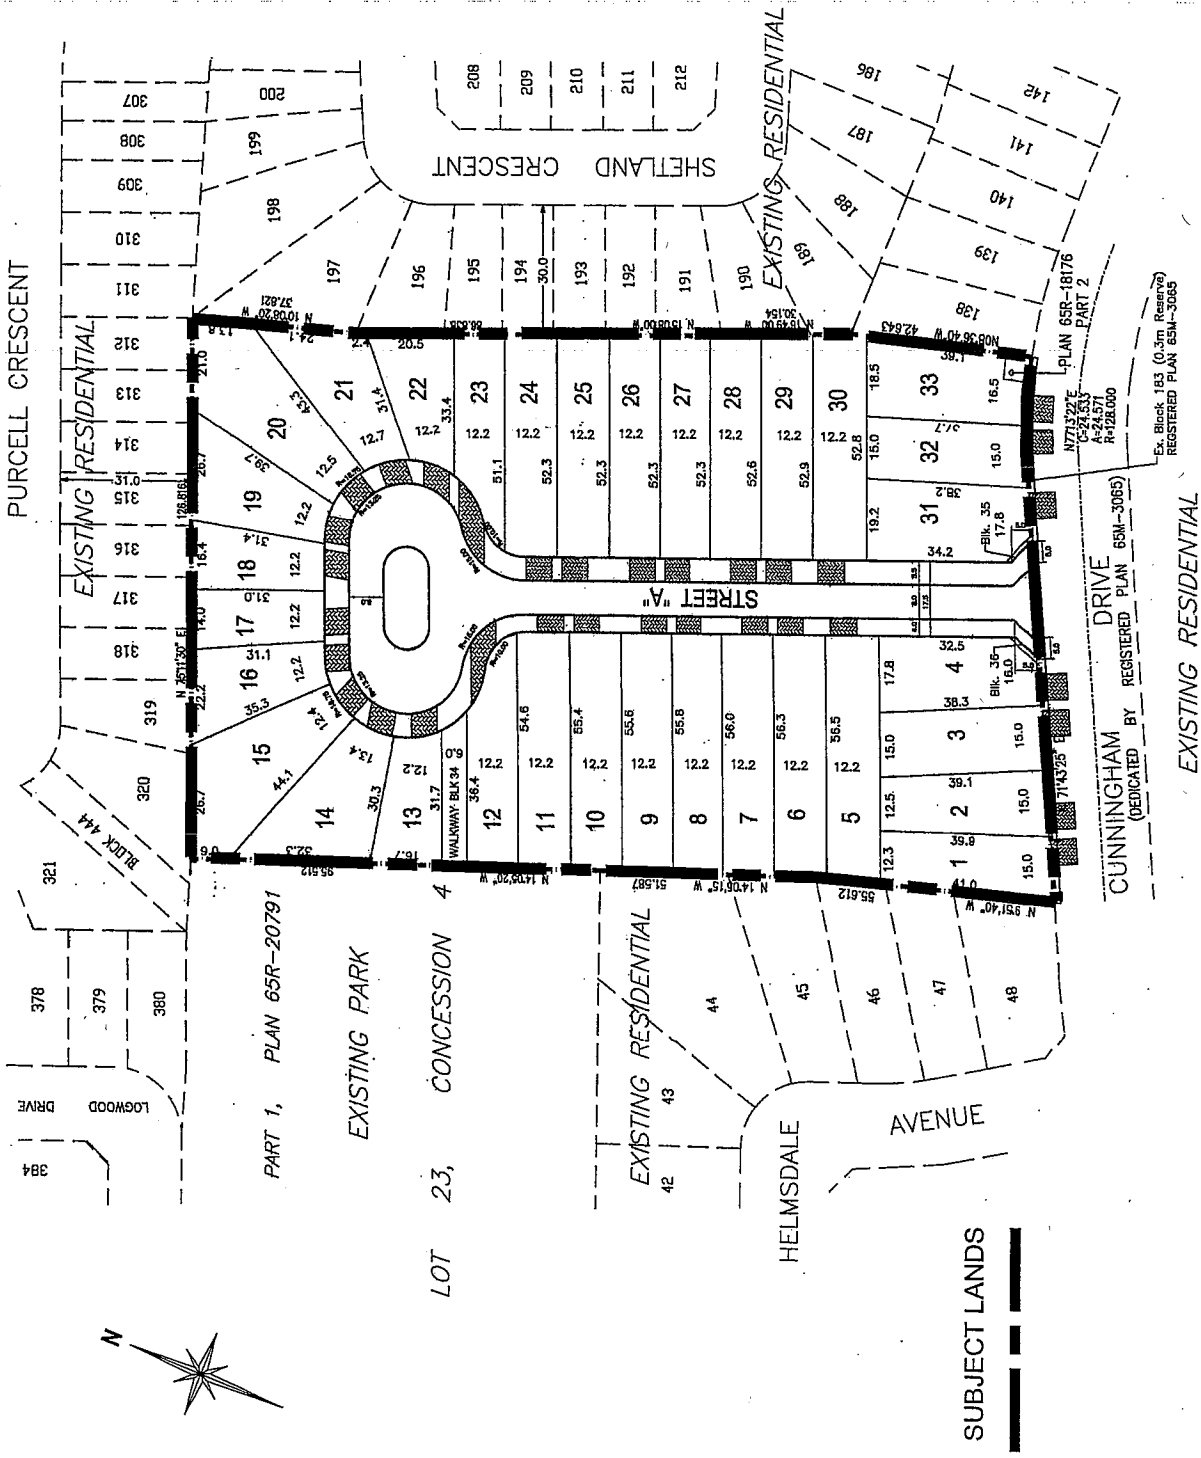

Draft Plan of Subdivision

Part Lot 23,
 Concession 4
 APPLICANT:
 MACKENZIE GLEN DEVELOPMENTS LIMITED
 N:\DFT\ ATTACHMENTS\19\191-04\07



Development Planning Department

Attachment

FILE No.:
 19T-04V07
 Not to Scale
 March 9, 2005

2